






DETAIL "A" INBOARD STEP
SCALE: 3/4" = 1'-0"

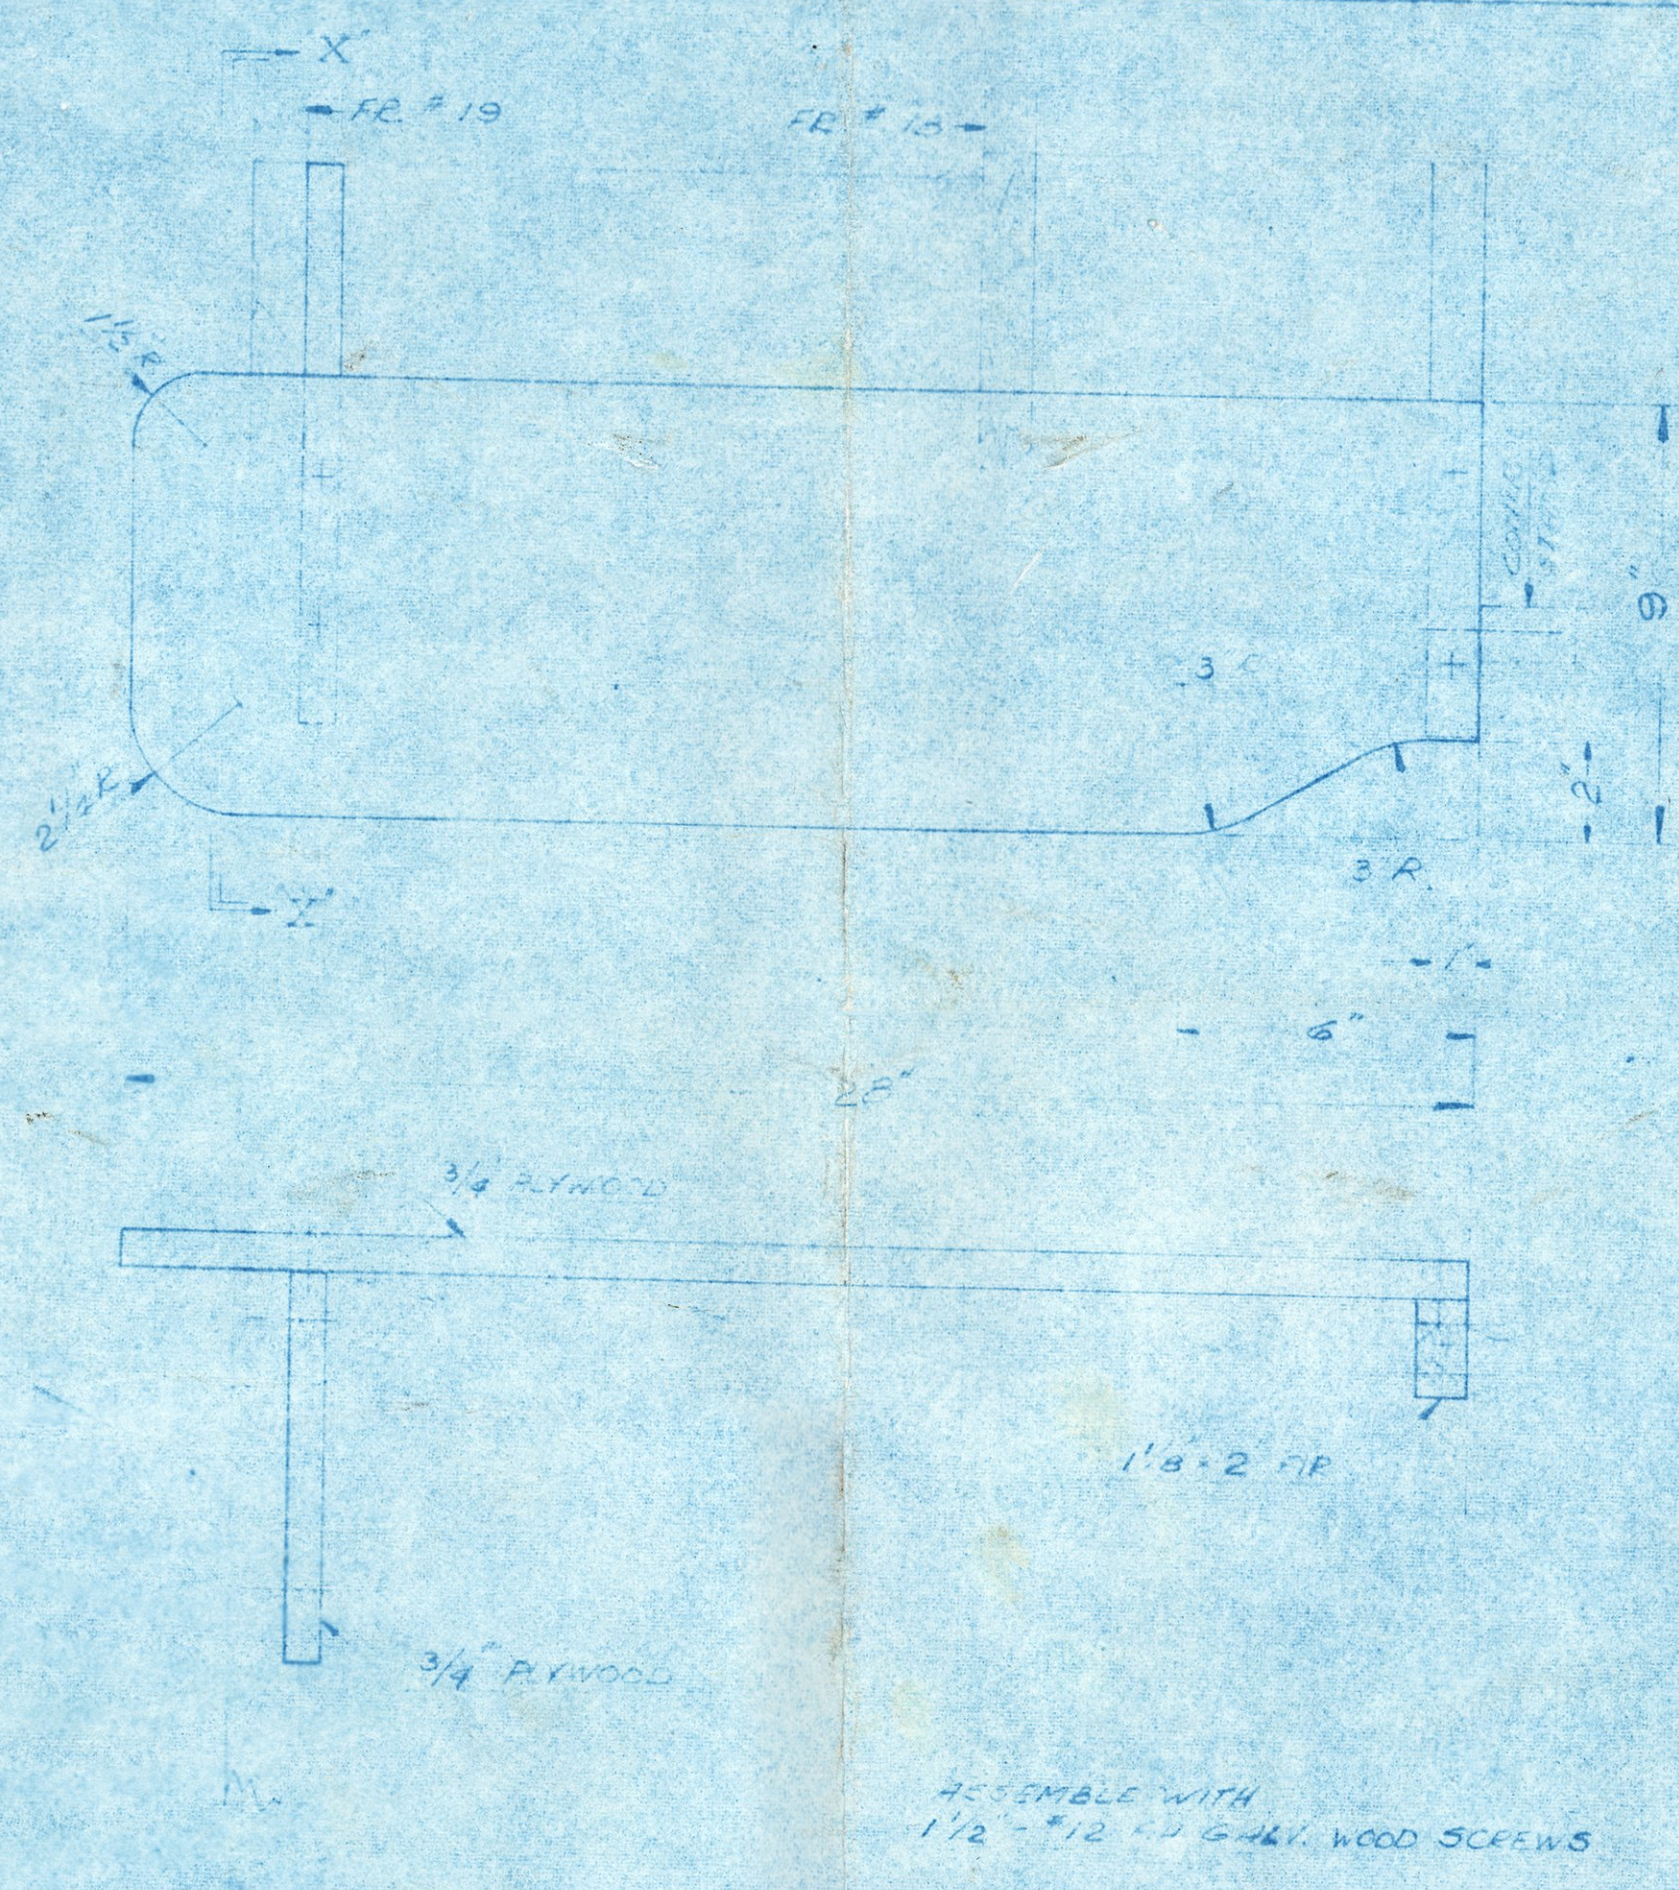


DETAIL "B" OUTBOARD STEP
SCALE: 3/4" = 1'-0"

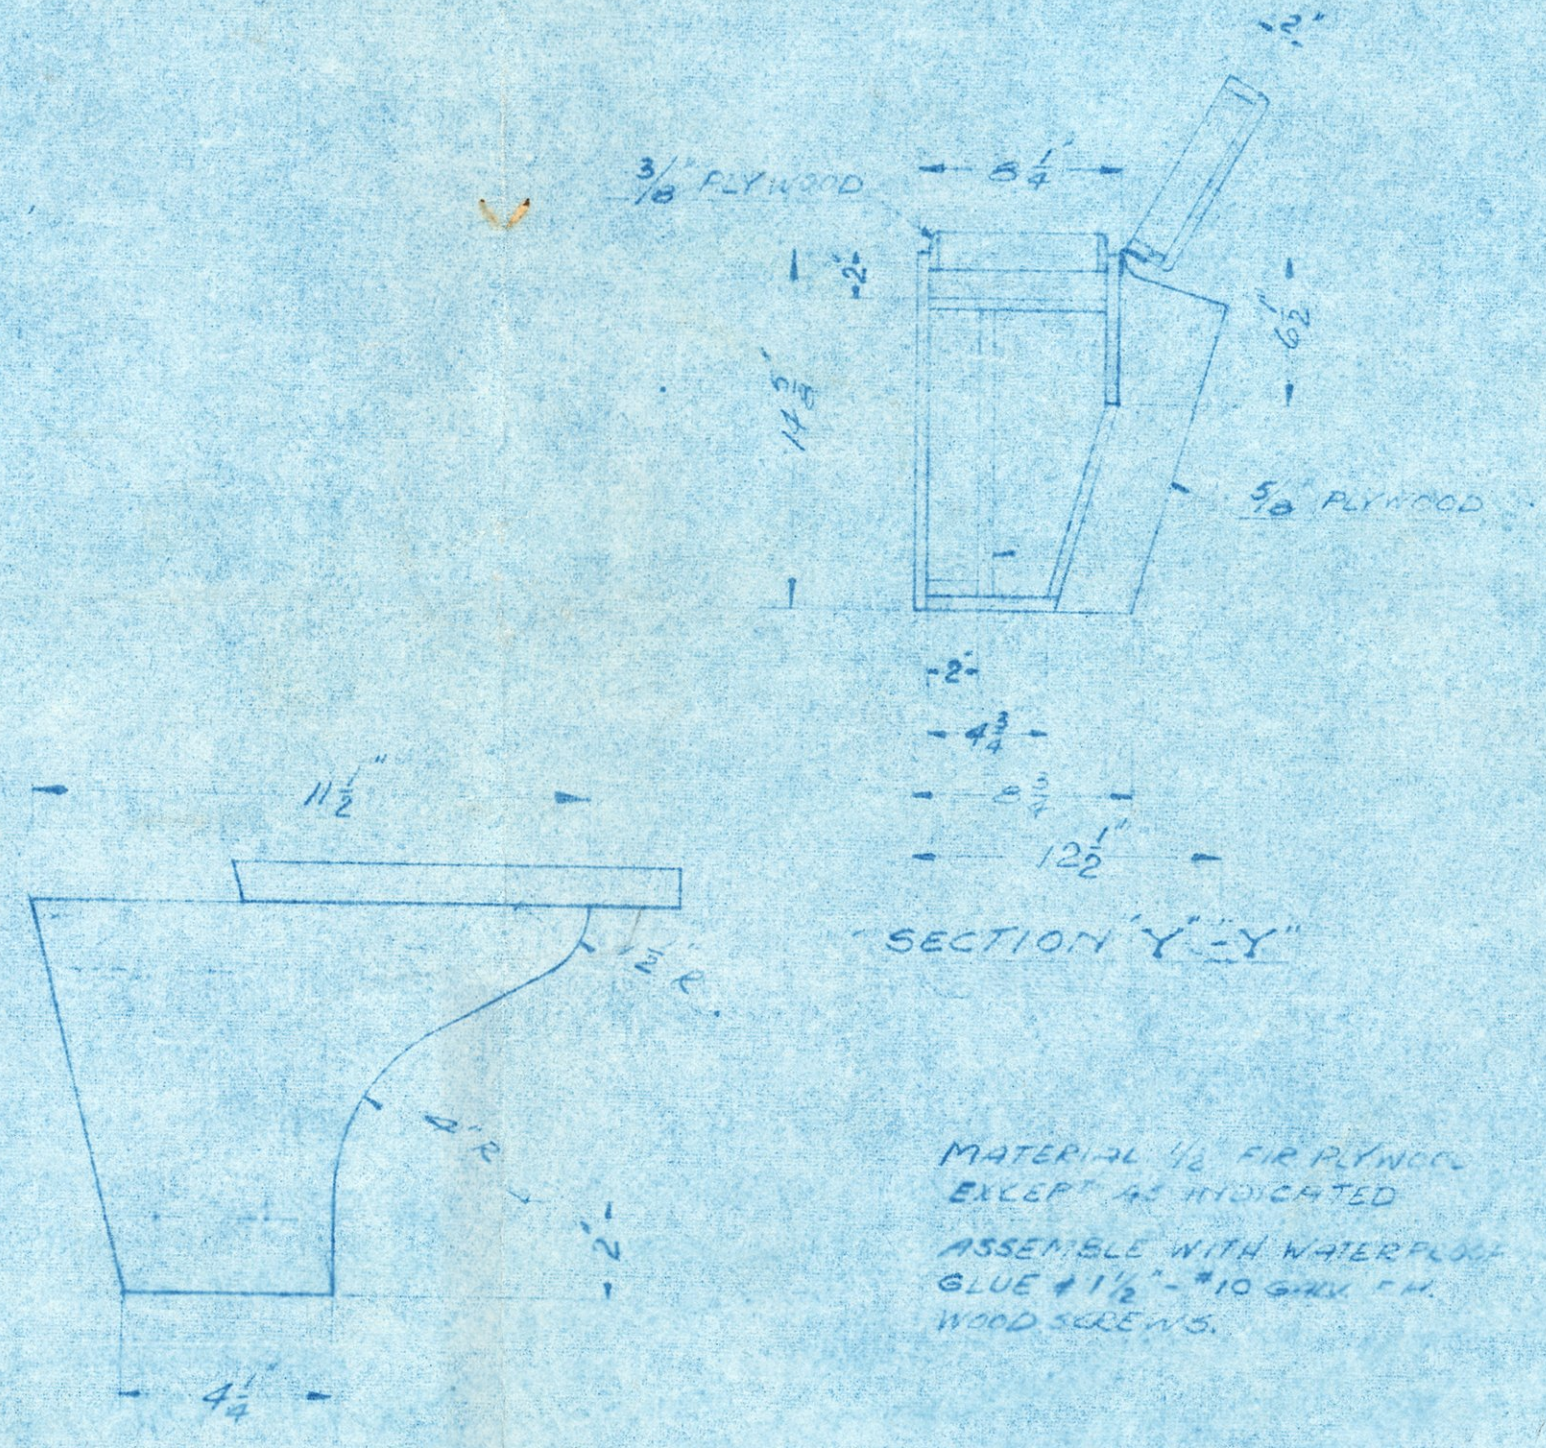

SECTION X-X

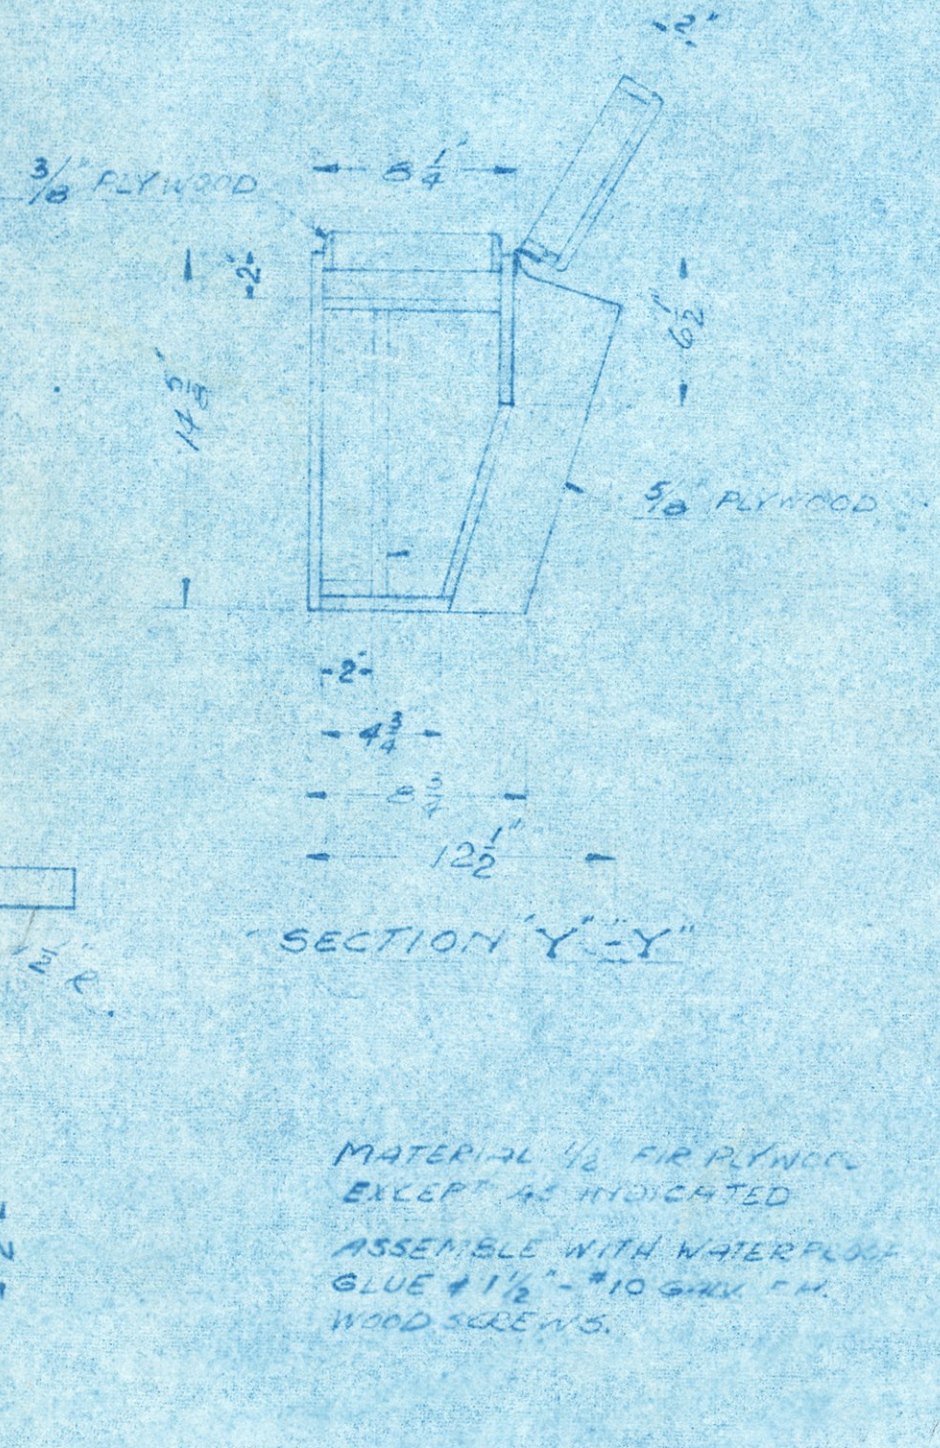

SECTION "Y-Y"

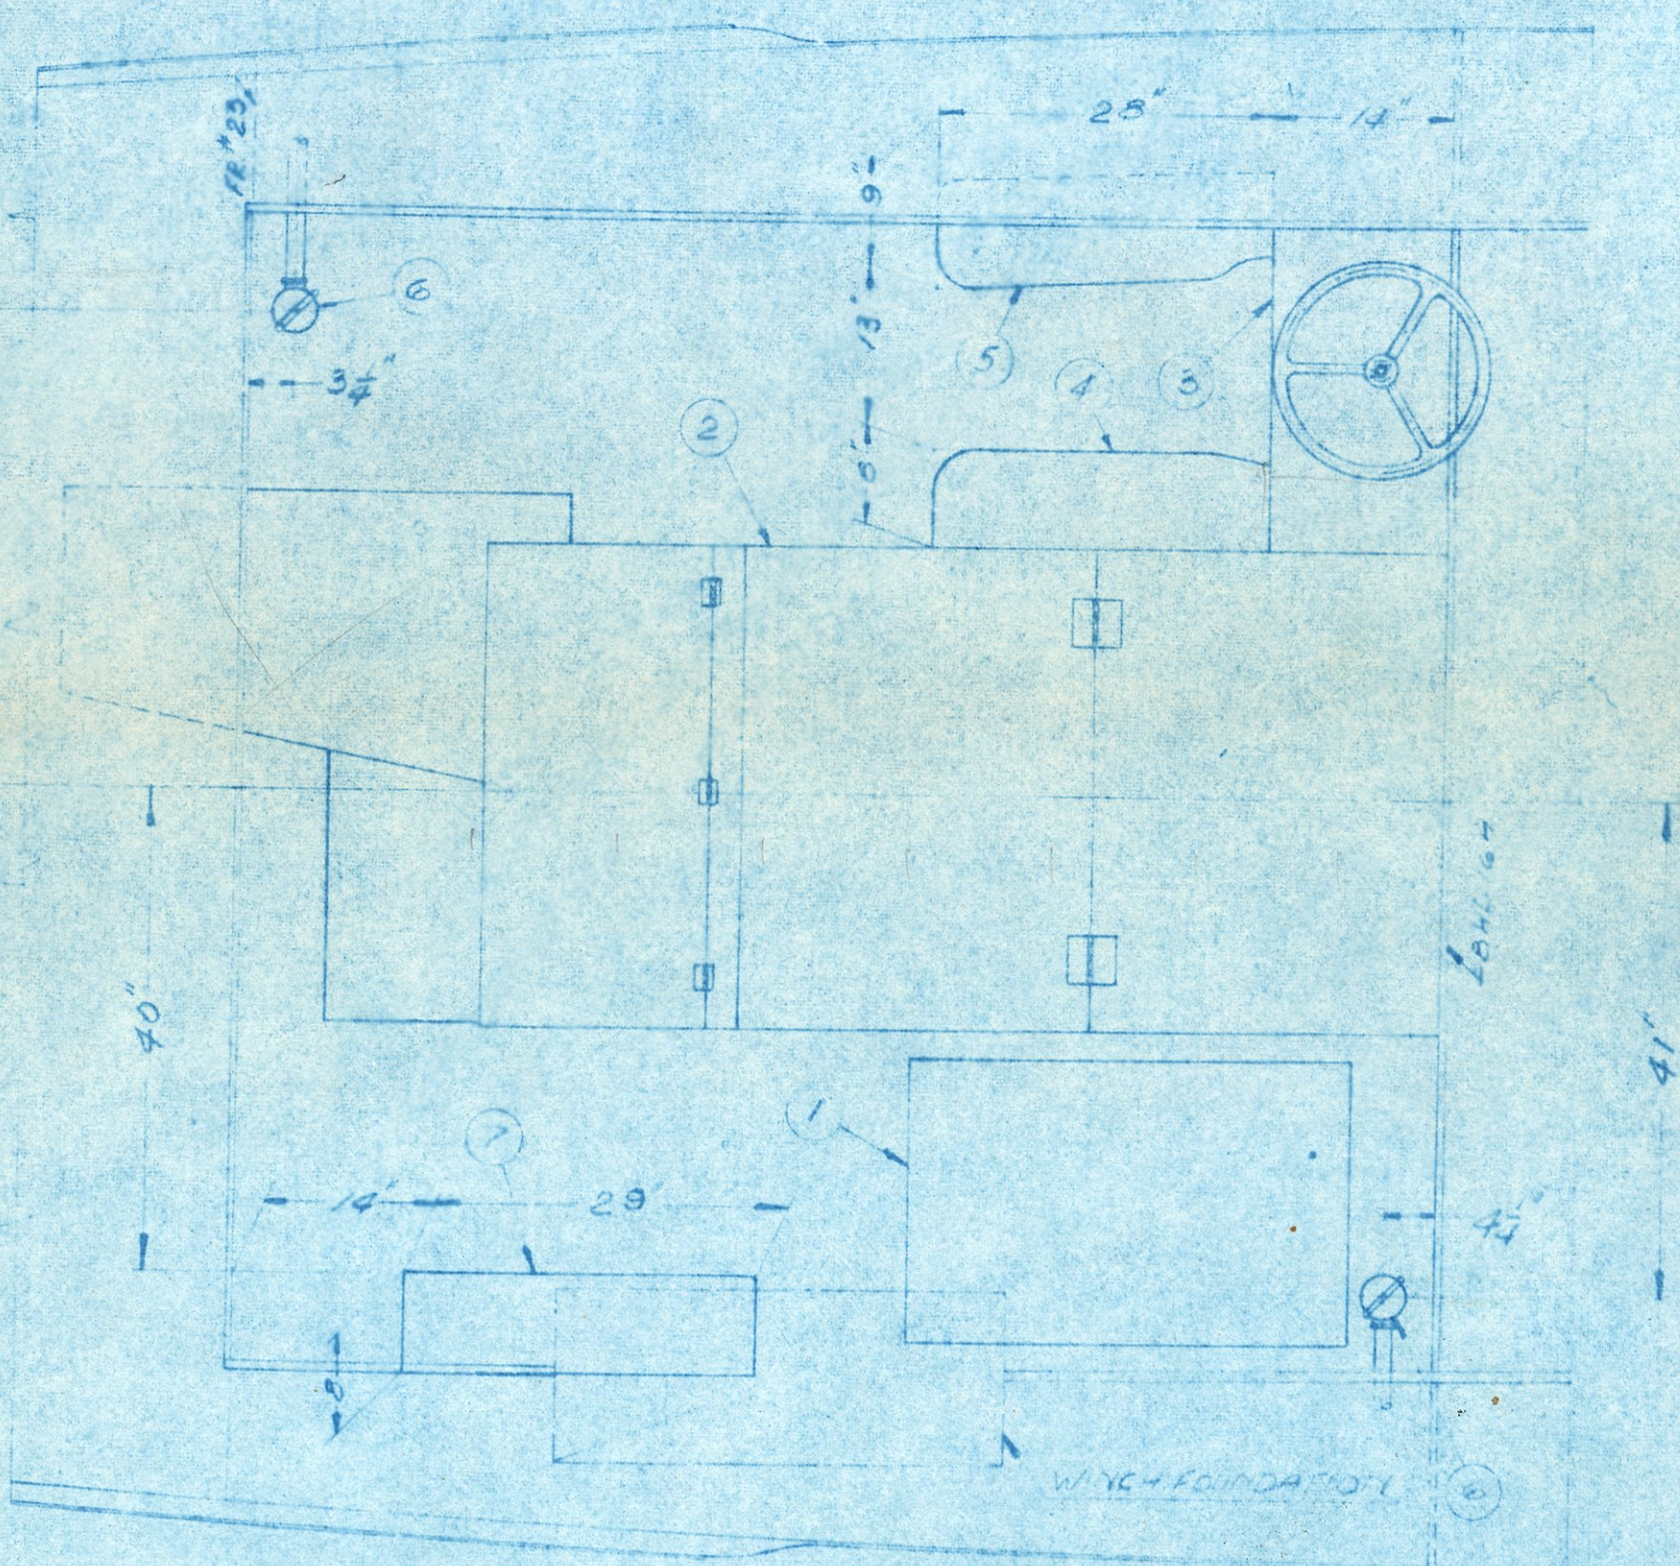

FLOOR PLAN
SCALE: 3/4" = 1'-0"

LIST OF EQUIPMENT REQUIRED FOR ONE BOAT			
ITEM NO.	NAME	QTY	REMARKS
1	BATTERY BOX	1	SEE REF NO 1
2	ENGINE ENCLOSURE	1	2
3	CONTROL STAND	1	3
4	INBOARD STEP	1	SEE DETAIL "A"
5	OUTBOARD STEP	1	SEE DETAIL "B"
6	HAND BILGE PUMP	2	ILLUSTRATION R-410 OF ES-04
7	ENGINEERS LOCKER	1	SEE DETAIL "C"

REVISIONS			
REV	DESCRIPTION	SUPP'D DATE	U.S.N. MARK
A	REVISED IN ACCORDANCE WITH CHANGING LETTER LCVP-1513 (42854-2644-1) DATED DEC. 30, 1954	2/1/55	1/1/55

Certified that this plan
has been modified to
represent the vessel
as constructed

M. J. Eklund 6/1/55
for SUPERVISOR OF SHIPBUILDING
USN & NIO, NEW YORK

REFERENCES		
NO.	TITLE	SHIPS PLAN NO.
1	DETAILS OF BATTERY BOX	LCVP-362-H-1377415
2	ENGINE ENCLOSURE	LCVP-511-H-1207563
3	CONTROL STAND	LCVP-52200-H-259524

THOMAS KNUTSON SHIPBUILDING CORP.
HALESITE, N.Y.

EXAMINED
OFFICIAL SIGNATURES

36 FT. LANDING CRAFT
LCVP

FLOOR PLAN BETWEEN FR. NO. 16A AND 23

REVIEWED

APPROVED *D. J. Ward* DATE 2/11/55

BUREAU OF SHIPS NO.

LCVP 50103 D 256923 A

SCALE: AS NOTED SH. 1 OF 1

258923